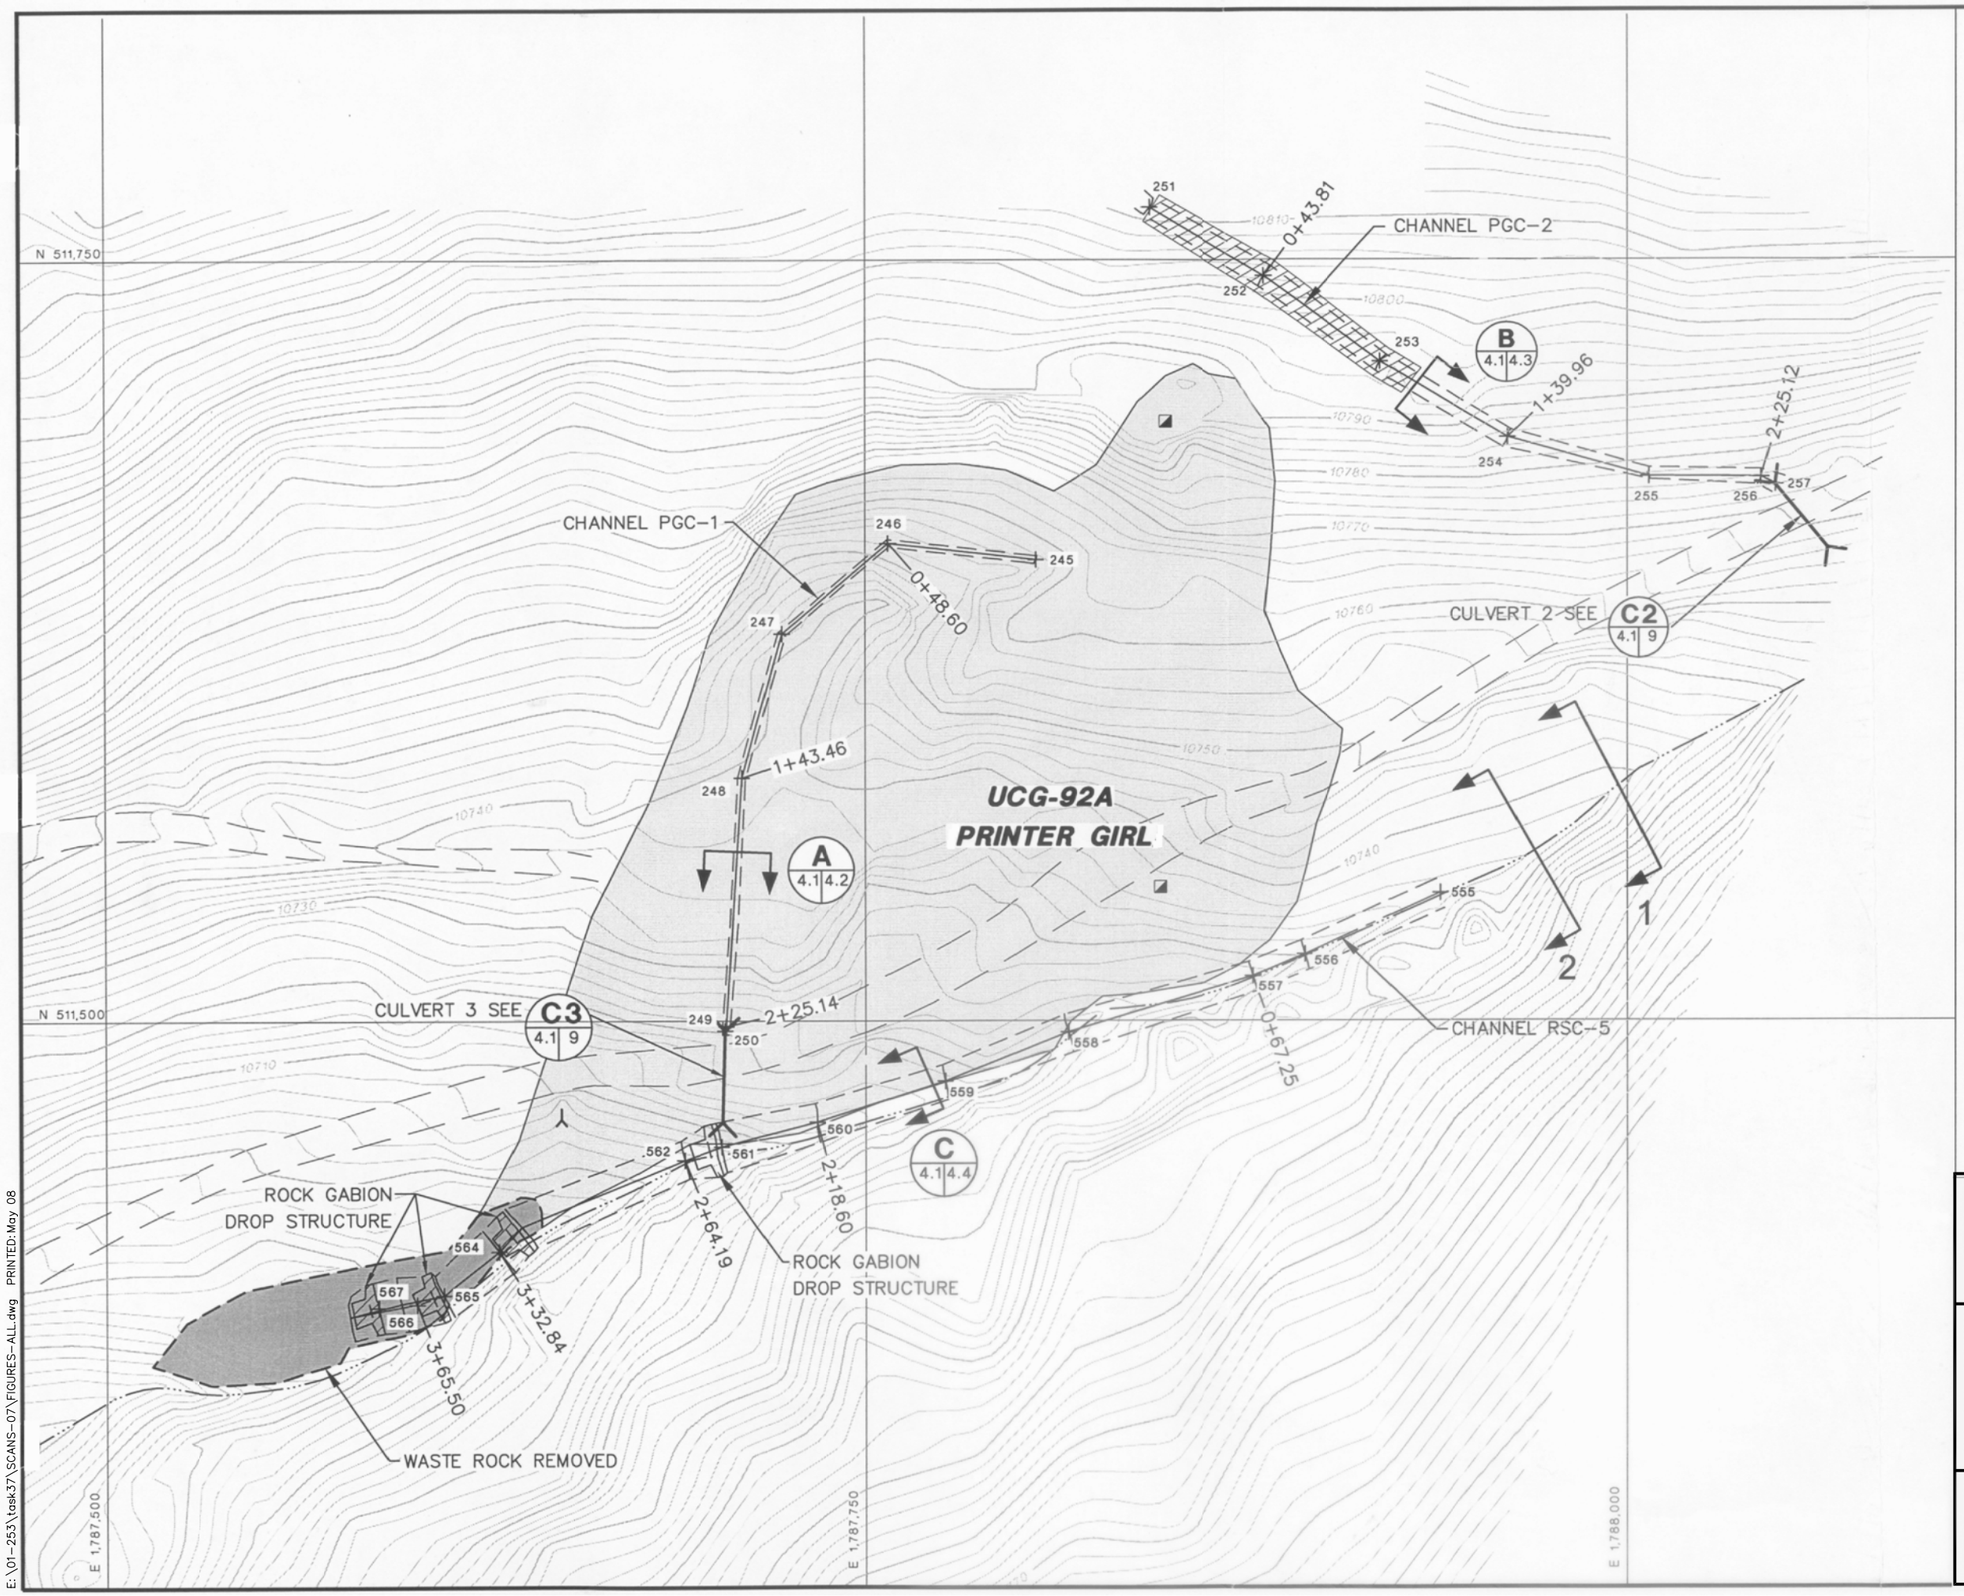

LEGEND

- REMOVED EXTENT OF ORIGINAL WASTE ROCK PILE
- APPROXIMATE EXTENT OF ORIGINAL WASTE ROCK PILE
- GCL
- CONTOURS
- REGRADED CONTOURS
- REGRADE BOUNDARY
- AS-BUILT CHANNEL CENTERLINE
- AS-BUILT CHANNEL EDGE OF CONCRETE
- +1 AS-BUILT CHANNEL CONTROL POINT
- 0+15.23 AS-BUILT CHANNEL CONTROL STATION
- AS-BUILT CULVERT LOCATION
- SHAFT
- PORTAL

NOTES:
1) EXISTING TOPOGRAPHY FROM SURVEY CONDUCTED BY INTRASEARCH INC., ENGLEWOOD, COLORADO 80111 OCTOBER 20, 1995).

2) AS-BUILT DATA FROM FIELD SURVEYS COMPLETED BY DEL MONT CONSULTANTS, MONTROSE, COLORADO 81402, SUMMER 1999 & 2000.

N

SCALE
25' 0 25' 50'
CONTOUR INTERVAL 2FT.

A 6 6
DETAIL/SECTION NUMBER
DRAWING No. WHERE DETAIL/SECTION IS REFERENCED
DRAWING No. WHERE DETAIL/SECTION IS SHOWN

CALIFORNIA GULCH SUPERFUND SITE

FIGURE 9
PRINTER GIRL (UCG-92A)
OU4

RESURRECTION MINING COMPANY
ONE UNITED BANK CENTER
1700 LINCOLN STREET
DENVER, COLORADO 80203

E:\01-253\task37\SCANS-07\FIGURES-ALL.dwg PRINTED: May 08

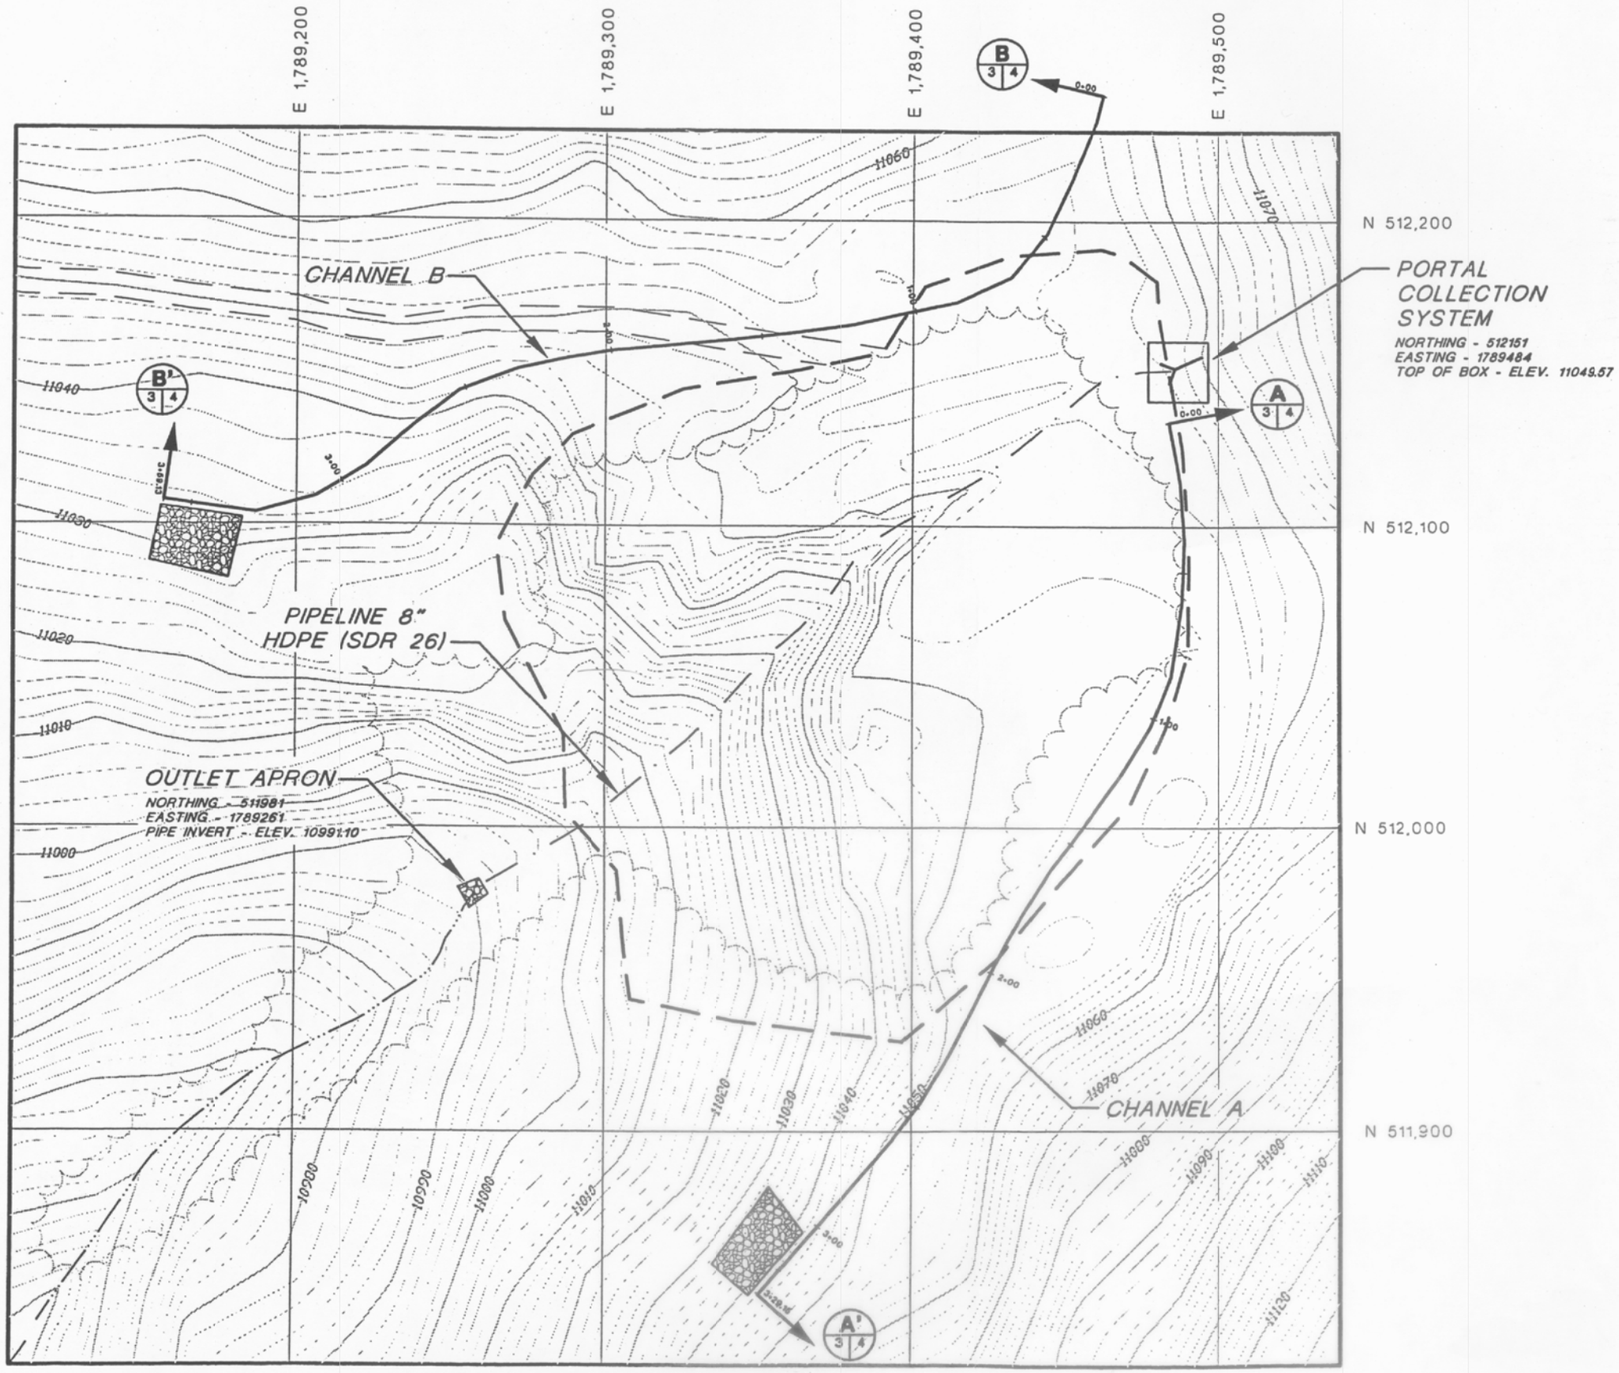

LEGEND

- PILE LIMIT
- TREE LINE
- DIVERSION CHANNEL
- PIPELINE
- PORTAL
- PORTAL COLLECTION SYSTEM LOCATION
- STREAM
- OUTLET APRON LOCATION

N

SCALE

25' 0 25' 50'

CONTOUR INTERVAL 2FT.

DETAIL/SECTION NUMBER

A
8 6

DRAWING No. WHERE DETAIL/SECTION IS REFERENCED

DRAWING No. WHERE DETAIL/SECTION IS SHOWN

CALIFORNIA GULCH SUPERFUND SITE

FIGURE 10
AGWALT (104)
OU4

RESURRECTION MINING COMPANY
ONE UNITED BANK CENTER
1700 LINCOLN STREET
DENVER, COLORADO 80203

E:\01-253\task37\SCANS-07\FIGURES-ALL.dwg PRINTED: May 08