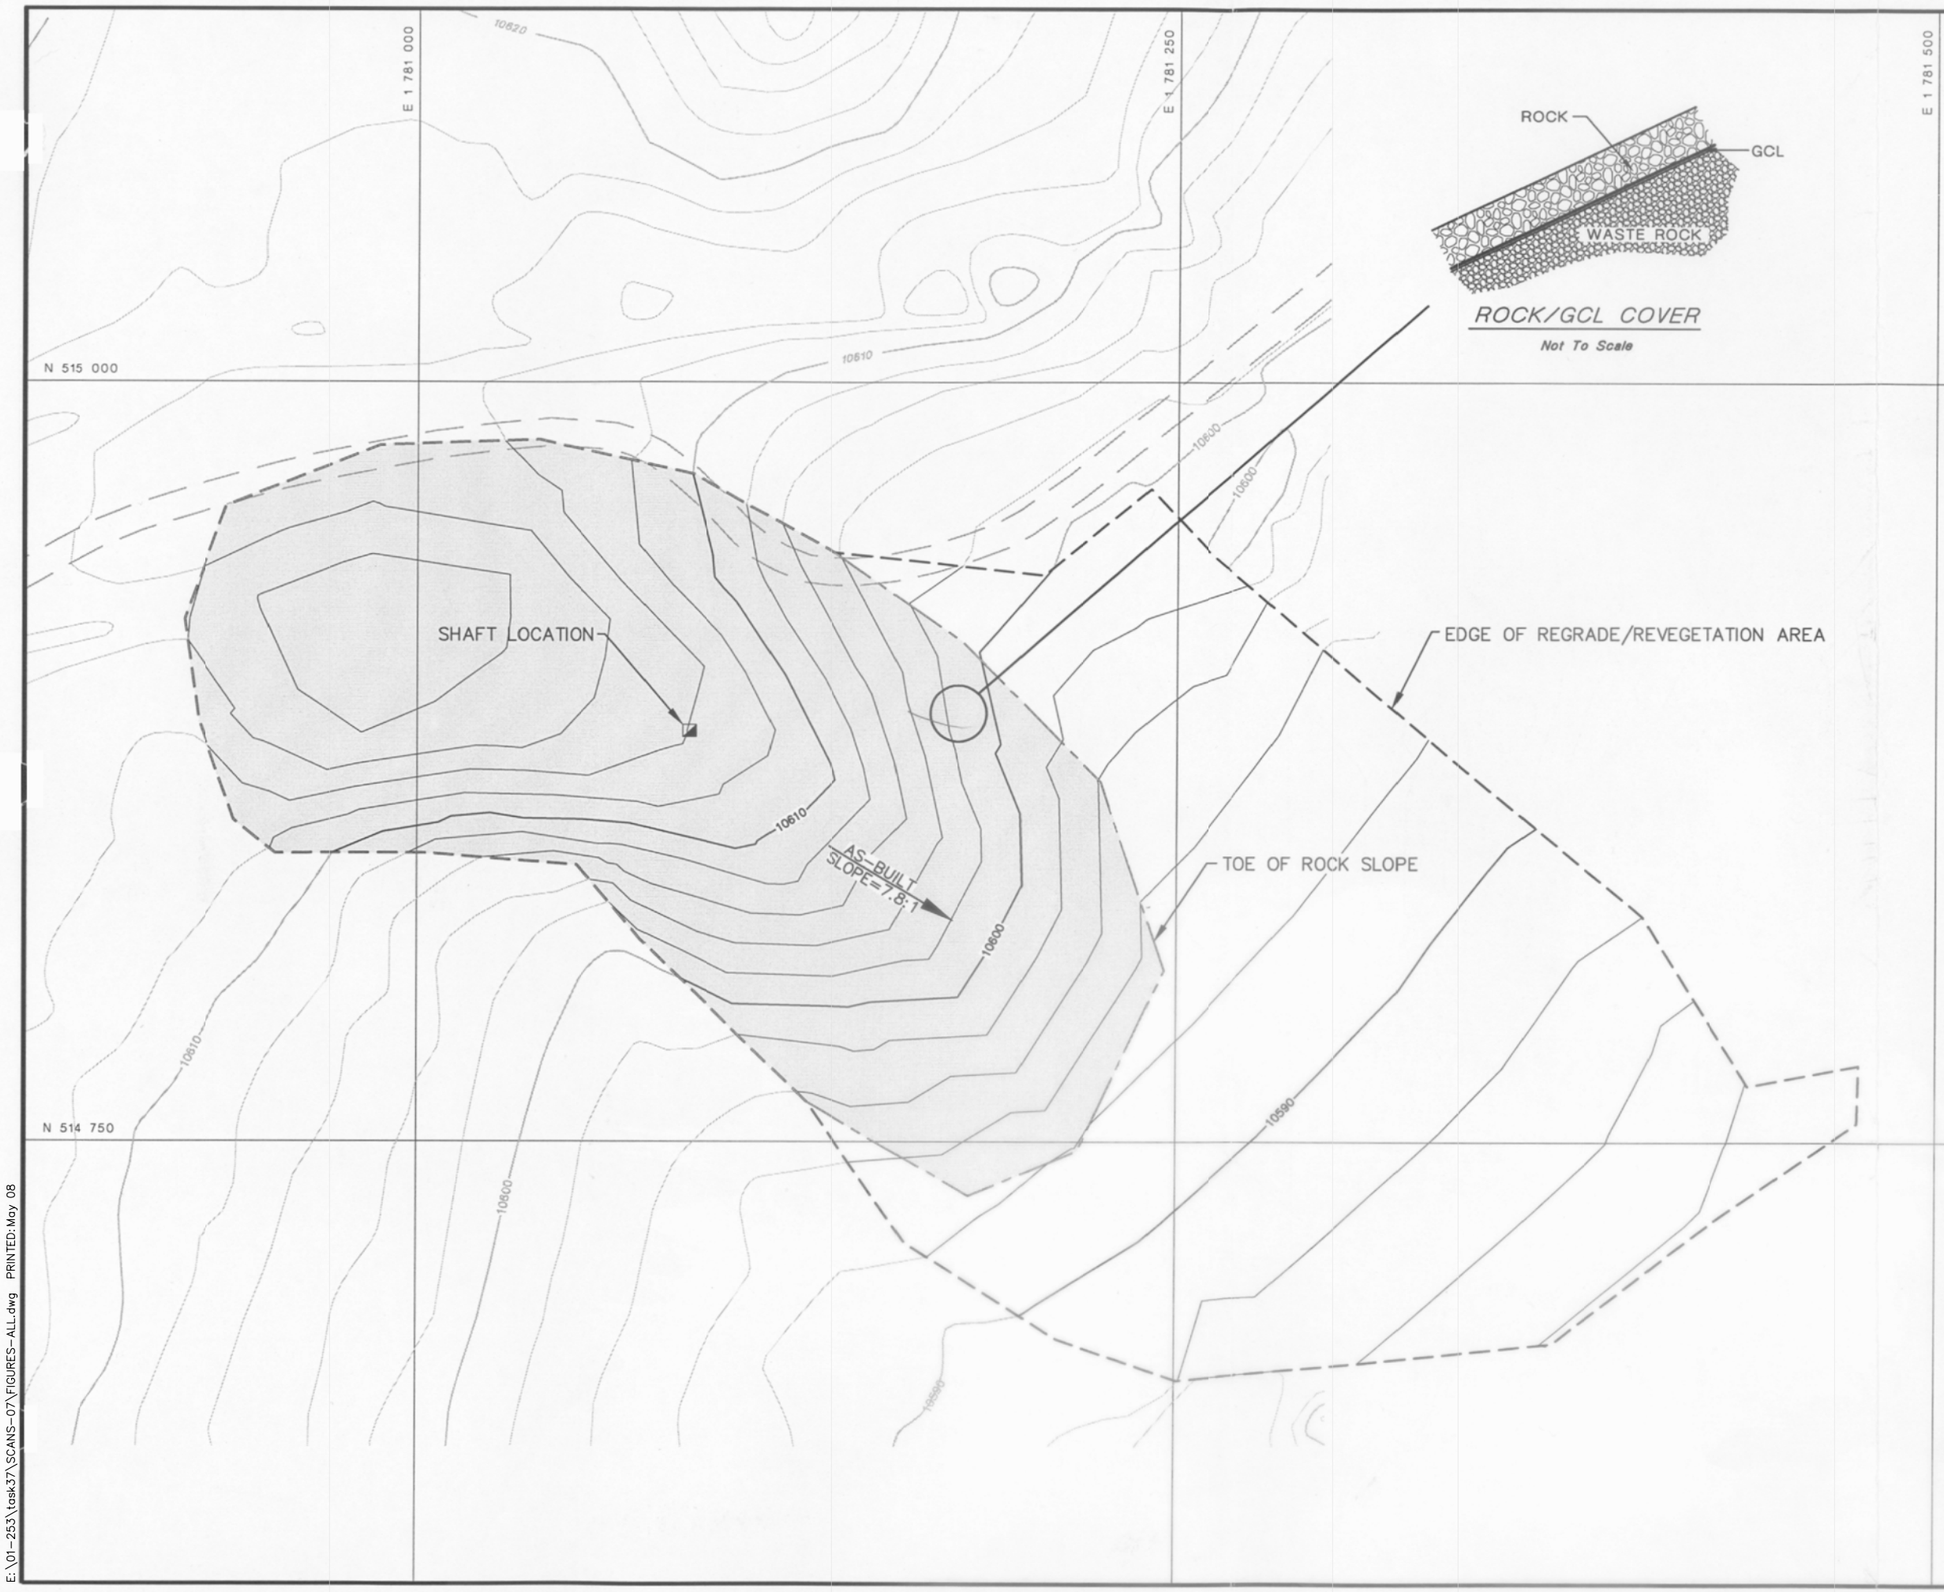

LEGEND

- DIRT ROAD
- UNDISTURBED CONTOURS
- REGRADED CONTOURS
- EDGE OF REGRADED AREA
- TOE OF ROCK SURFACE
- REGRADED / COVERED WASTE ROCK

NOTES:
1) ORIGINAL TOPOGRAPHY FROM SURVEY CONDUCTED BY INTRASEARCH INC., ENGLEWOOD, COLORADO 80111 (OCTOBER 20, 1995).

2) AS-BUILT INFORMATION FROM FIELD SURVEYS CONDUCTED BY DELMONT CONSULTANTS, INC, MONTROSE. COLORADO (1999 & 2000)

N

SCALE
25' 0 25' 50'
CONTOUR INTERVAL 2FT.

CALIFORNIA GULCH SUPERFUND SITE

FIGURE 13
MAB-IRON HILL (UCG12)

RESURRECTION MINING COMPANY
ONE UNITED BANK CENTER
1700 LINCOLN STREET
DENVER. COLORADO 80203

E:\01-253\task37\SCANS-07\FIGURES-ALL.dwg PRINTED: May 08

E 1,760,000
E 1,765,000
E 1,770,000
E 1,775,000
E 1,780,000
N 515,000
N 510,000
N 505,000

CITY OF LEADVILLE
APACHE TAILING IMPOUNDMENT
FLUVIAL TAILING SITE 3
FLUVIAL TAILING SITE 6
NON-RESIDENTIAL SOILS AREA 6
LoPLATA SLAG PILE
FLUVIAL TAILING SITE 1
FLUVIAL TAILING SITE 2
CZL TAILING IMPOUNDMENT SITE
A-V SMELTER SITE
SKI CLUB AREA
NON-RESIDENTIAL SOILS AREA 5
OREGON GULCH
GEORGIA GULCH
OREGON GULCH TAILING IMPOUNDMENT
YAK TUNNEL TREATMENT PLANT
YAK TUNNEL
CALIFORNIA GULCH
STRAY HORSE GULCH
TAILING REMOVAL REVEGETATION AREAS
ARKANSAS RIVER
MALTA GULCH
NON-RESIDENTIAL SOILS AREA 4
NON-RESIDENTIAL SOILS AREA 3
AIRPORT GULCH
PAWNEE GULCH
CALIFORNIA GULCH
U.S. HIGHWAY 24
FLUVIAL TAILING SITE 8
NON-RESIDENTIAL SOILS AREA 2
NON-RESIDENTIAL SOILS AREA 1
IOWA GULCH

LEGEND

- CALIFORNIA GULCH SITE BOUNDARY
- OPERABLE UNIT 8 BOUNDARY
- FLUVIAL TAILING SITE BOUNDARY
- SLAG PILE
- TAILING IMPOUNDMENT

N

SCALE
1000' 0 1000' 2000'
CONTOUR INTERVAL N.A.

CALIFORNIA GULCH SUPERFUND SITE

FIGURE 14
SITE LOCATION MAP
OU8

RESURRECTION MINING COMPANY
ONE UNITED BANK CENTER
1700 LINCOLN STREET
DENVER, COLORADO 80203

E:\01-253\task37\SCANS-07\FIGURES-ALL.dwg PRINTED: May 08